



**NOTE:**  
COORDINATE PRIMARY ELECTRIC SERVICE FOR UC HEALTH WITH PVREA PRIOR TO CONSTRUCTION

# CONFORMED TO CONSTRUCTION RECORD

**WRD4 GREELEY PROPERTY LLC**  
2775 71ST AVE  
APN: 09591740002

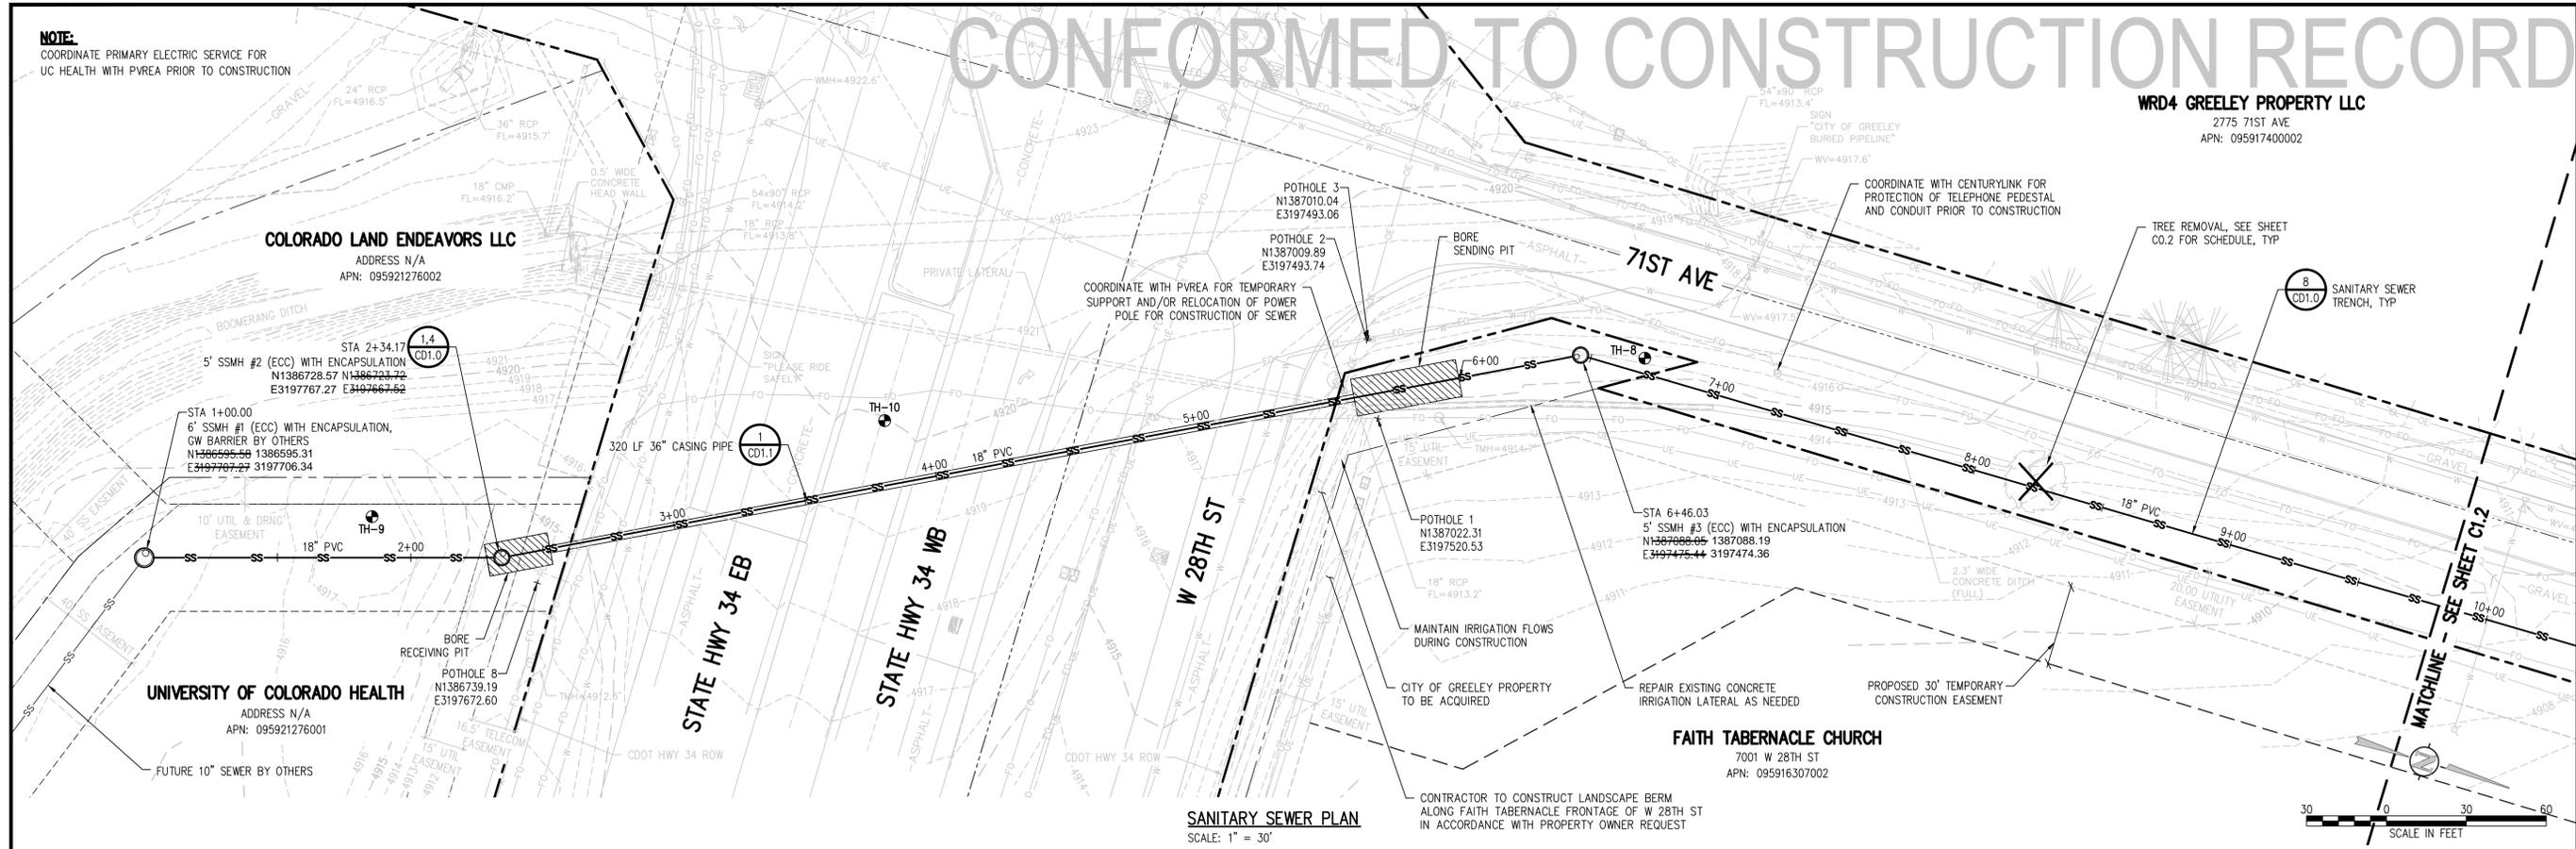

**SANITARY SEWER PLAN**  
SCALE: 1" = 30'

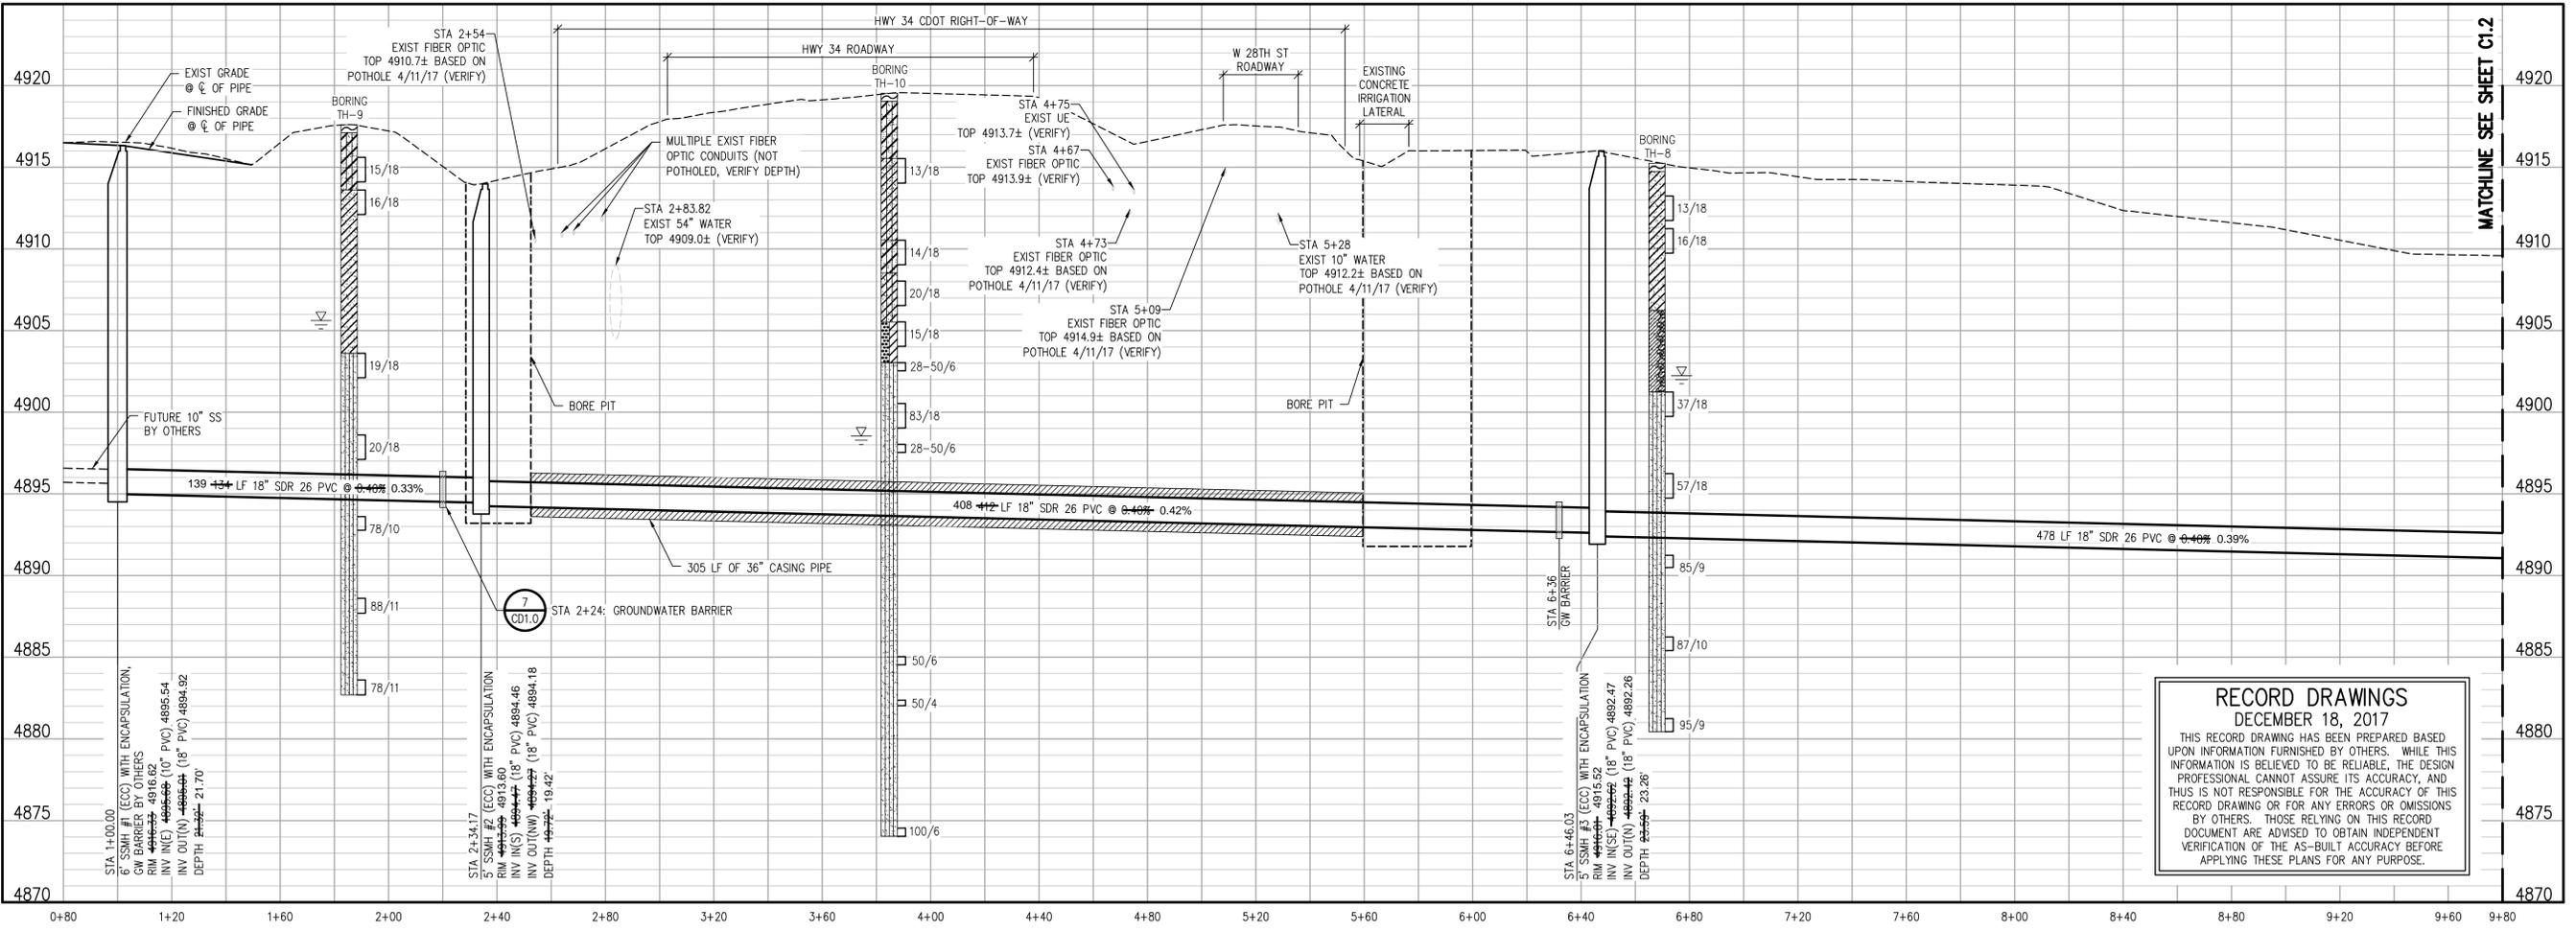

**SANITARY SEWER PROFILE**  
SCALE: 1" = 30' HORIZ  
1" = 5' VERT

**RECORD DRAWINGS**  
DECEMBER 18, 2017

THIS RECORD DRAWING HAS BEEN PREPARED BASED UPON INFORMATION FURNISHED BY OTHERS. WHILE THIS INFORMATION IS BELIEVED TO BE RELIABLE, THE DESIGN PROFESSIONAL CANNOT ASSURE ITS ACCURACY, AND THIS IS NOT RESPONSIBLE FOR THE ACCURACY OF THIS RECORD DRAWING OR FOR ANY ERRORS OR OMISSIONS BY OTHERS. THOSE RELYING ON THIS RECORD DOCUMENT ARE ADVISED TO OBTAIN INDEPENDENT VERIFICATION OF THE AS-BUILT ACCURACY BEFORE APPLYING THESE PLANS FOR ANY PURPOSE.


NO.	DATE	DES'D	DWN	REVISION DESCRIPTION

DESIGNED BY: KRBLAT  
DRAWN BY: KRBLAT  
CHECKED BY: JIM  
JOB #: 2597.1c  
DATE: 05/05/2017  
© JVA INC


ASHCROFT DRAW BASIN SANITARY SEWER  
PHASE I  
SANITARY SEWER PLAN AND PROFILE

SHEET NO.  
**C1.1**


# CONFORMED TO CONSTRUCTION RECORD

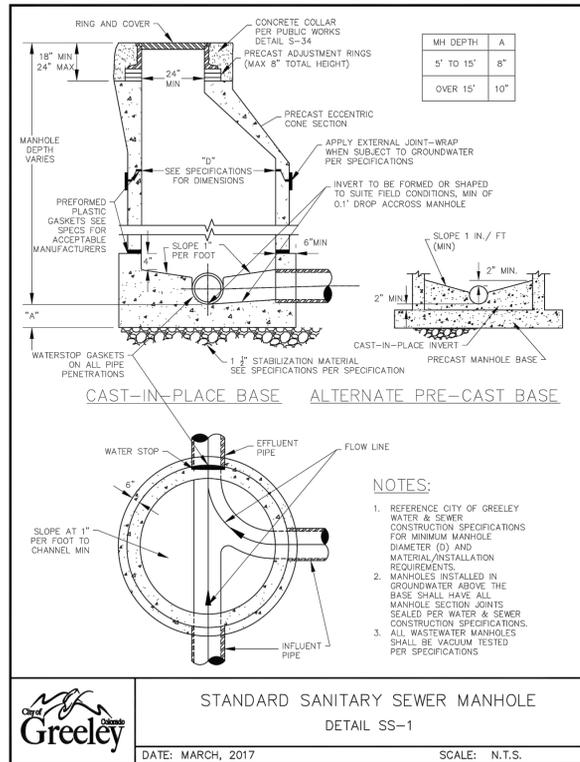


1  
C1.1

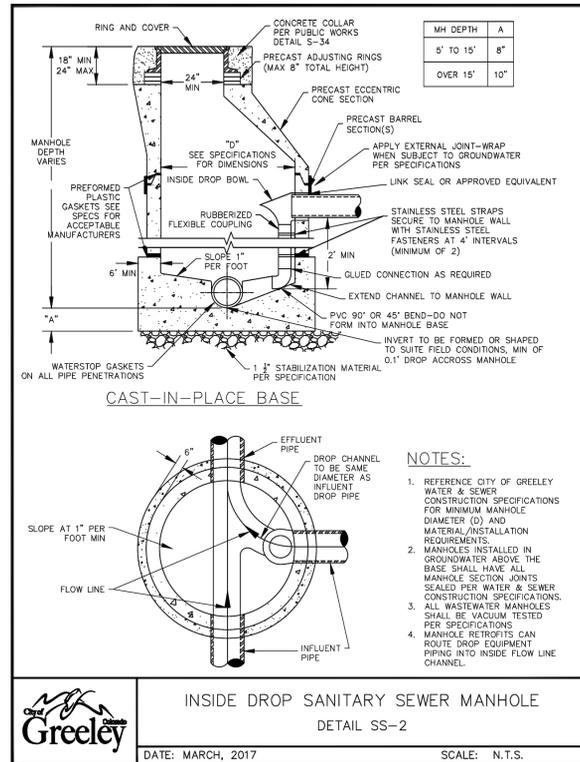

2  
C1.5

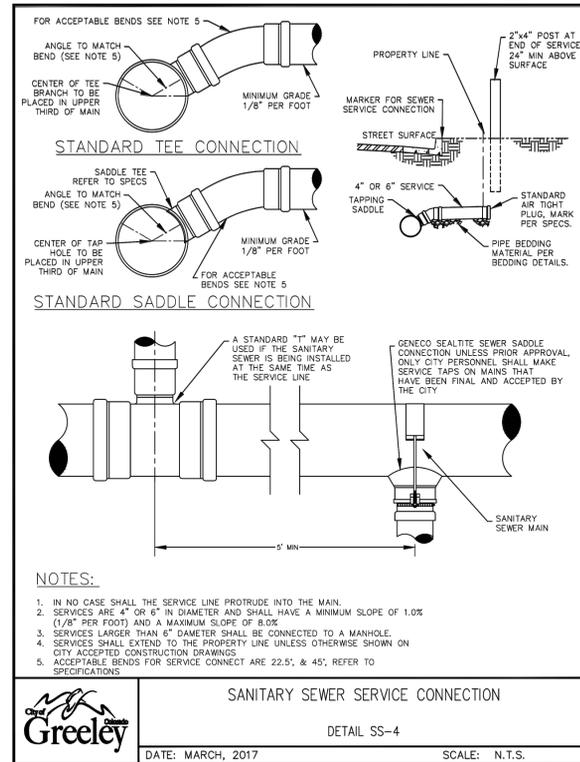


3  
C1.3

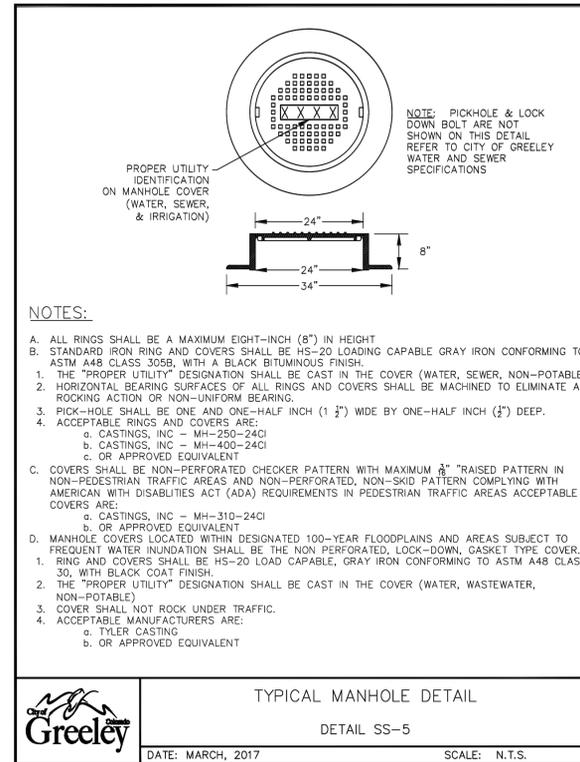


4  
C1.1


**RECORD DRAWINGS**  
 DECEMBER 18, 2017  
 THIS RECORD DRAWING HAS BEEN PREPARED BASED UPON INFORMATION FURNISHED BY OTHERS. WHILE THIS INFORMATION IS BELIEVED TO BE RELIABLE, THE DESIGN PROFESSIONAL CANNOT ASSURE ITS ACCURACY, AND THIS IS NOT RESPONSIBLE FOR THE ACCURACY OF THIS RECORD DRAWING OR FOR ANY ERRORS OR OMISSIONS BY OTHERS. THOSE RELYING ON THIS RECORD DOCUMENT ARE ADVISED TO OBTAIN INDEPENDENT VERIFICATION OF THE AS-BUILT ACCURACY BEFORE APPLYING THESE PLANS FOR ANY PURPOSE.

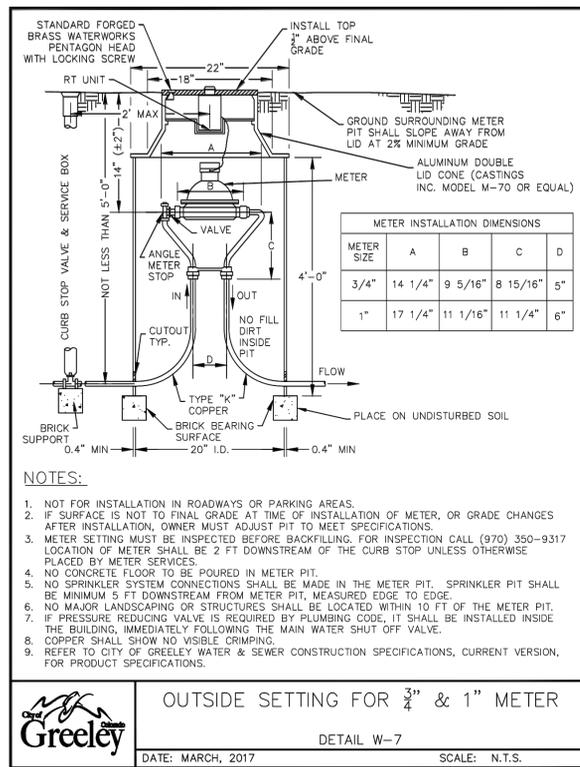


5  
C1.3

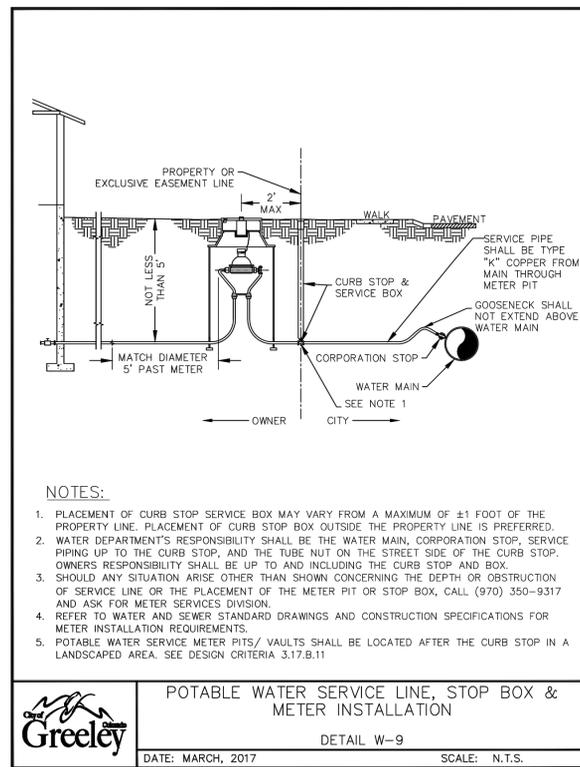

6  
C1.3

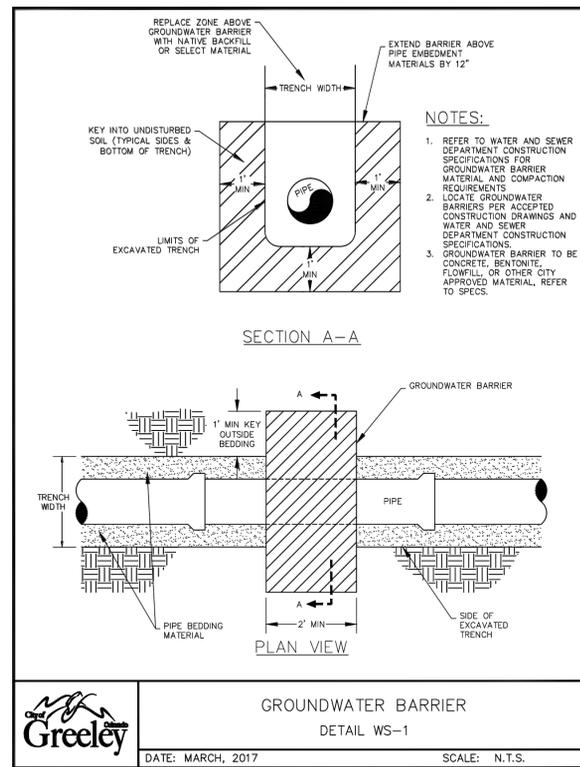

7  
C1.1

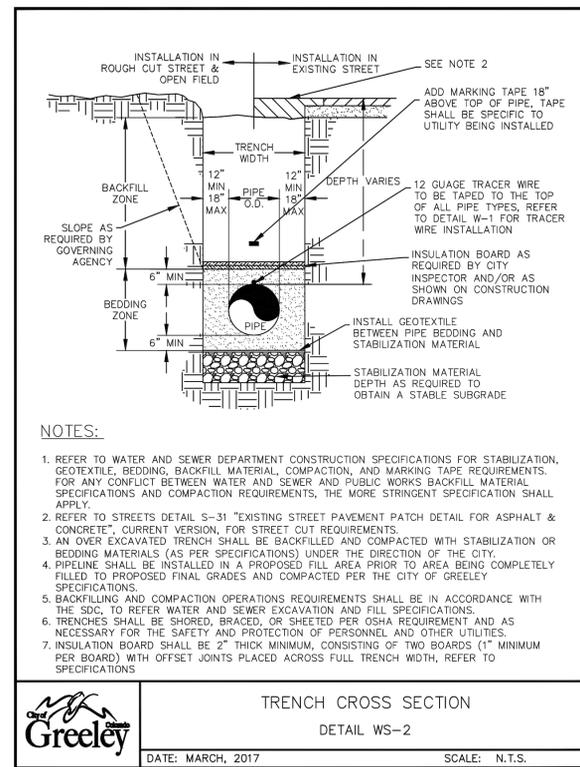

8  
C1.1

REVISION DESCRIPTION  
 NO. DATE DESD DWN

DESIGNED BY: KRBLAT  
 DRAWN BY: KRBLAT  
 CHECKED BY: JIM  
 JOB #: 2597.1c  
 DATE: 05/05/2017  
 © JVA INC

ASHCROFT DRAW BASIN SANITARY SEWER  
 PHASE I  
 DETAILS